
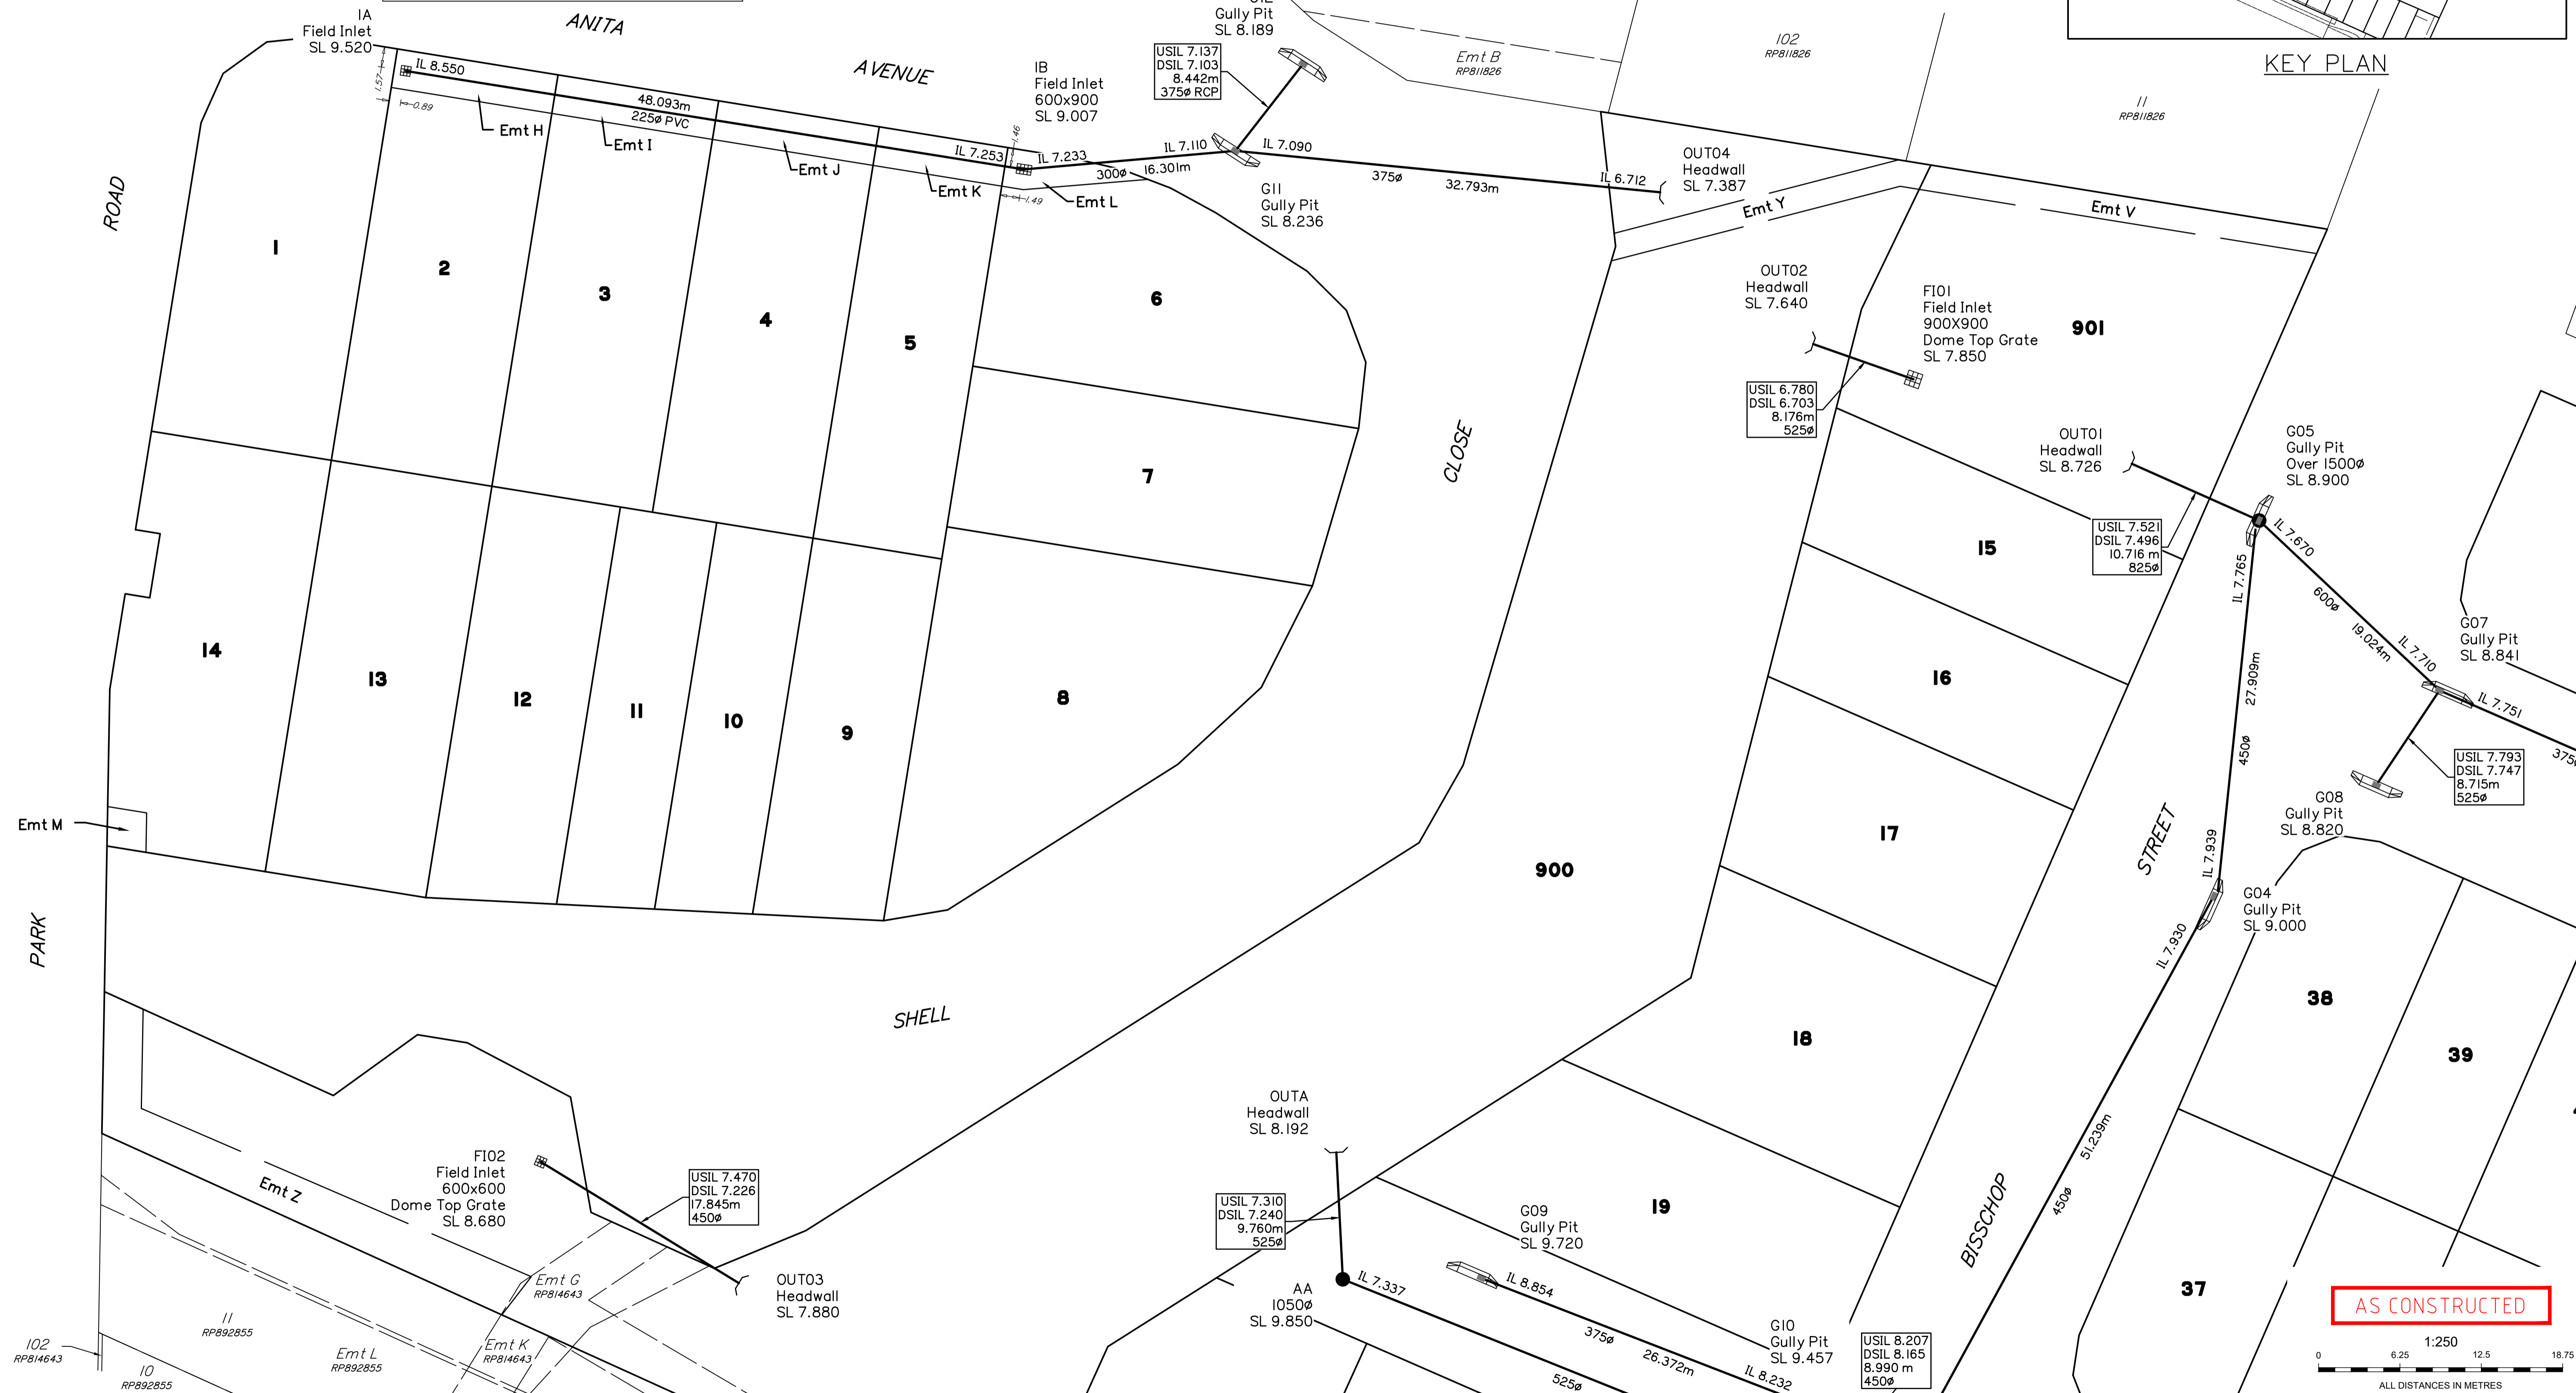



**Registered Surveyor's Certification:**  
 I, DTS Group QLD Pty Ltd, being a registered/licensed surveyor and duly authorised representative of DTS Group Qld Pty Ltd hereby:  
 - Certify the information contained in this drawing is an accurate "as constructed" representation of the works.  
 - Accept responsibility for the "as constructed" information contained in this drawing.  
 - Acknowledge the "as constructed" information contained in the drawing may be relied on by Council and others.  
 Certification for Stage 1 & 2 by .....  
 on 12/10/2020 for DTS Group QLD Pty Ltd  
 Reg Surveyor No.: 3115

**Consulting Engineer's Certification:**  
 I, ..... being a certified/registered engineer and duly authorised representative of Premise Engineers hereby:  
 - Certify the information in this drawing is an accurate "as constructed" representation of the works.  
 - Accept responsibility for the "as constructed" information contained in this drawing.  
 - Acknowledge the "as constructed" information contained in the drawing may be relied on by Council and others.  
 Certification for Stages 1 & 2 by .....  
 on ..... for KN Group Pty Ltd  
 RPEQ: .....

- All pipes are Class '2' Reinforced Concrete Pipes (RCP) unless noted otherwise.
- All manholes are 1050Ø with Cast Iron, Circular lids, unless noted otherwise.
- All Field Pits are 600x600 with Galvanised Grated lids unless noted otherwise.
- All bedding to pipes is Type '3' unless noted otherwise.
- Year of construction 2020.

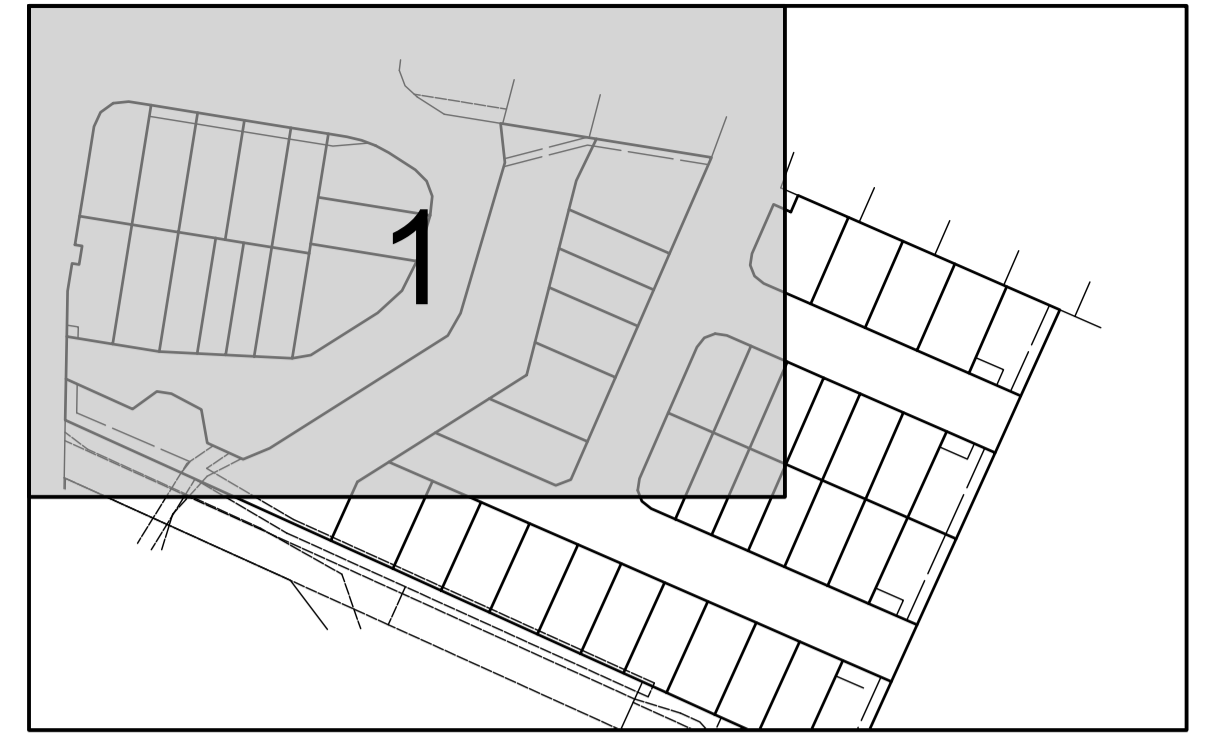

**AS CONSTRUCTED**

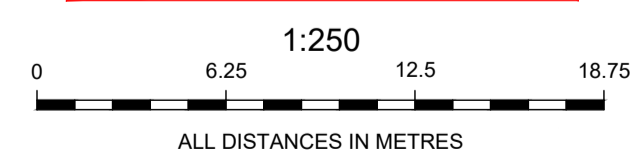

ISSUE	DATE	AS CONSTRUCTED	REVISIONS	DRAWN	CHECKED	PASSED
A	12/10/2020	AS CONSTRUCTED		AA	RC	

**dts** urban planning, surveying & development  
 Brisbane PO Box 3128, West End QLD 4101 Ph: 07 3118 0600  
 Mackay PO Box 11711, Mackay Queensland QLD 4740 Ph: 1300 278 783

DRAWN	CHECKED	PASSED	INITIALS	DATE
AA	RC			17/09/2020
				17/09/2020



**Moreton Bay Regional Council**  
 Regional Council

**Moreton Bay Regional Council**  
**Real Property Description**  
 Lots 1-14 & 900 on SP315044 and  
 Lots 15-49 & 901 on SP315045  
 Locality of Deception Bay  
 Datum for Levels PM 36278 RL 9.154m AHD

**Bayside Estate Stages 1 & 2**  
 16-28 Park Road,  
 Deception Bay  
**AS CONSTRUCTED DRAINAGE**

SCALE	DTS Ref:	DRAWING No.	SHEET
1:250 (A1)	BNE180539	A1-1396-D-1	1 of 2 SHEETS

Oct 12, 2020 - 1:32pm

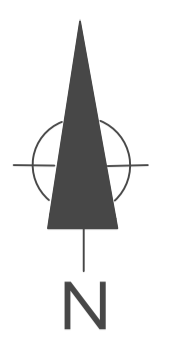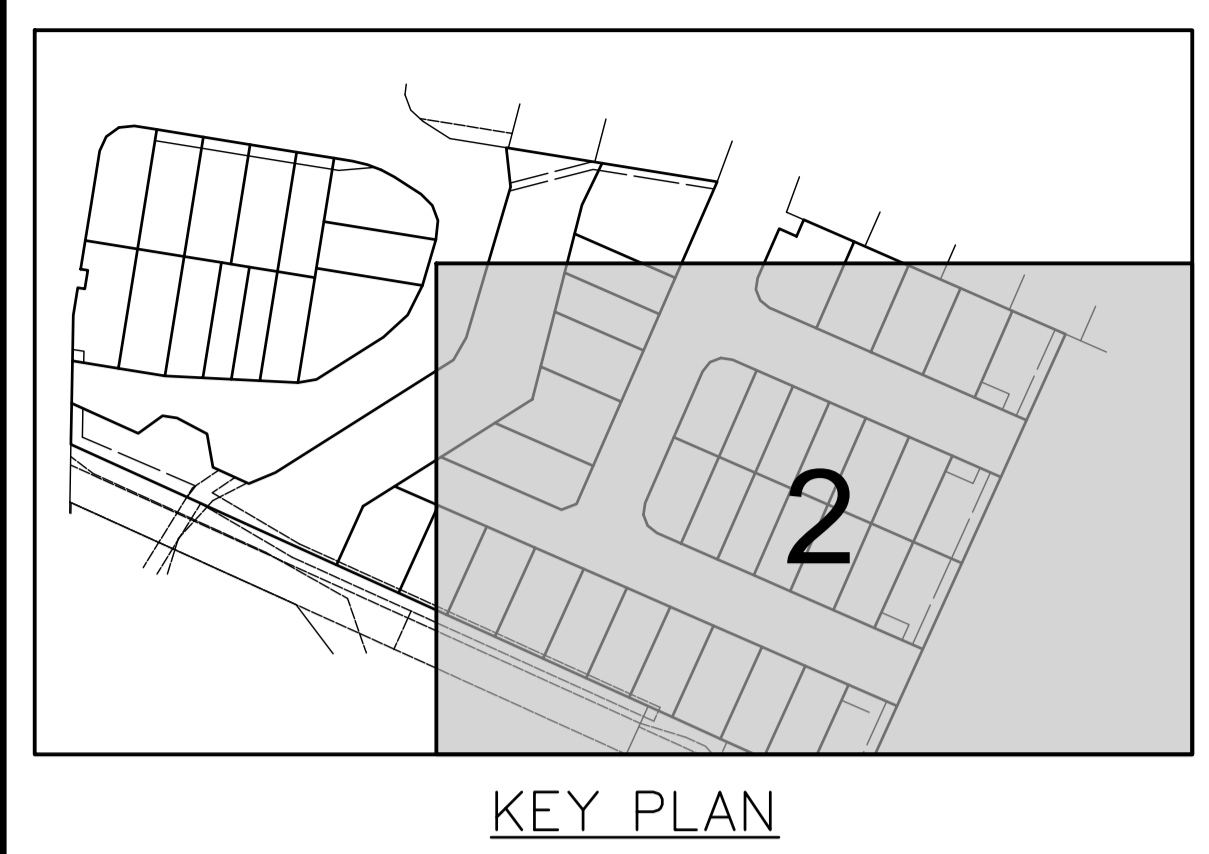

1. All pipes are Class '2' Reinforced Concrete Pipes (RCP) unless noted otherwise.
2. All manholes are 1050Ø with Cast Iron, Circular lids, unless noted otherwise.
3. All Field Pits are 600x600 with Galvanised Grated lids unless noted otherwise.
4. All bedding to pipes is Type '3' unless noted otherwise.
5. Year of construction 2020.

**Registered Surveyor's Certification:**

I, DTS Group QLD Pty Ltd, being a registered/licensed surveyor and duly authorised representative of DTS Group QLD Pty Ltd hereby:

- Certify the information contained in this drawing is an accurate "as constructed" representation of the works.
- Accept responsibility for the "as constructed" information contained in this drawing.
- Acknowledge the "as constructed" information contained in the drawing may be relied on by Council and others.

Certification for Stage 1 & 2 by: *[Signature]*  
 on 12/10/2020 for DTS Group QLD Pty Ltd  
 Reg Surveyor No.: 3115


**Consulting Engineer's Certification:**

I, being a certified/registered engineer and duly authorised representative of Premise Engineers hereby:

- Certify the information in this drawing is an accurate "as constructed" representation of the works.
- Accept responsibility for the "as constructed" information contained in this drawing.
- Acknowledge the "as constructed" information contained in the drawing may be relied on by Council and others.

Certification for Stages 1 & 2 by: .....  
 on ..... for KN Group Pty Ltd  
 RPEQ: .....

**AS CONSTRUCTED**

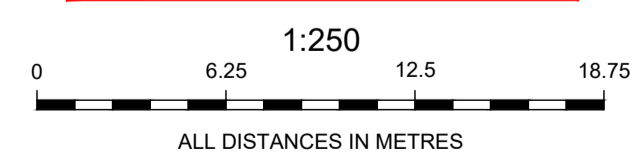

ISSUE	DATE	AS CONSTRUCTED	REVISIONS	DRAWN	CHECKED	PASSED
A	12/10/2020	AS CONSTRUCTED		AA	RC	

**dts** urban planning, surveying & development

Brisbane PO Box 3128, West End QLD 4101  
 Ph: 07 3118 0600  
 brisbane@dtsqld.com.au

Mackay PO Box 11711, Mackay Capeland QLD 4740  
 Ph: 1300 276 783  
 mackay@dtsqld.com.au

DRAWN	AA	17/09/2020
CHECKED	RC	17/09/2020
PASSED		
INITIALS		DATE

**Moreton Bay Regional Council**

**Real Property Description**  
 Lots 1-14 & 900 on SP315044 and  
 Lots 15-49 & 901 on SP315045  
 Locality of Deception Bay  
 Datum for Levels PM 36278 RL 9.154m AHD

**Bayside Estate**  
 Stages 1 & 2  
 16-28 Park Road,  
 Deception Bay

**AS CONSTRUCTED DRAINAGE**

SCALE	1:250 (A1)
DTS Ref:	BNE180539
DRAWING No.	A1-1396-D-2
SHEET	2 of 2 SHEETS

Oct 12, 2020 - 1:32pm